


FLOOR 3 HALLWAY HSSD#4 SCHEMATIC

SCALE: None

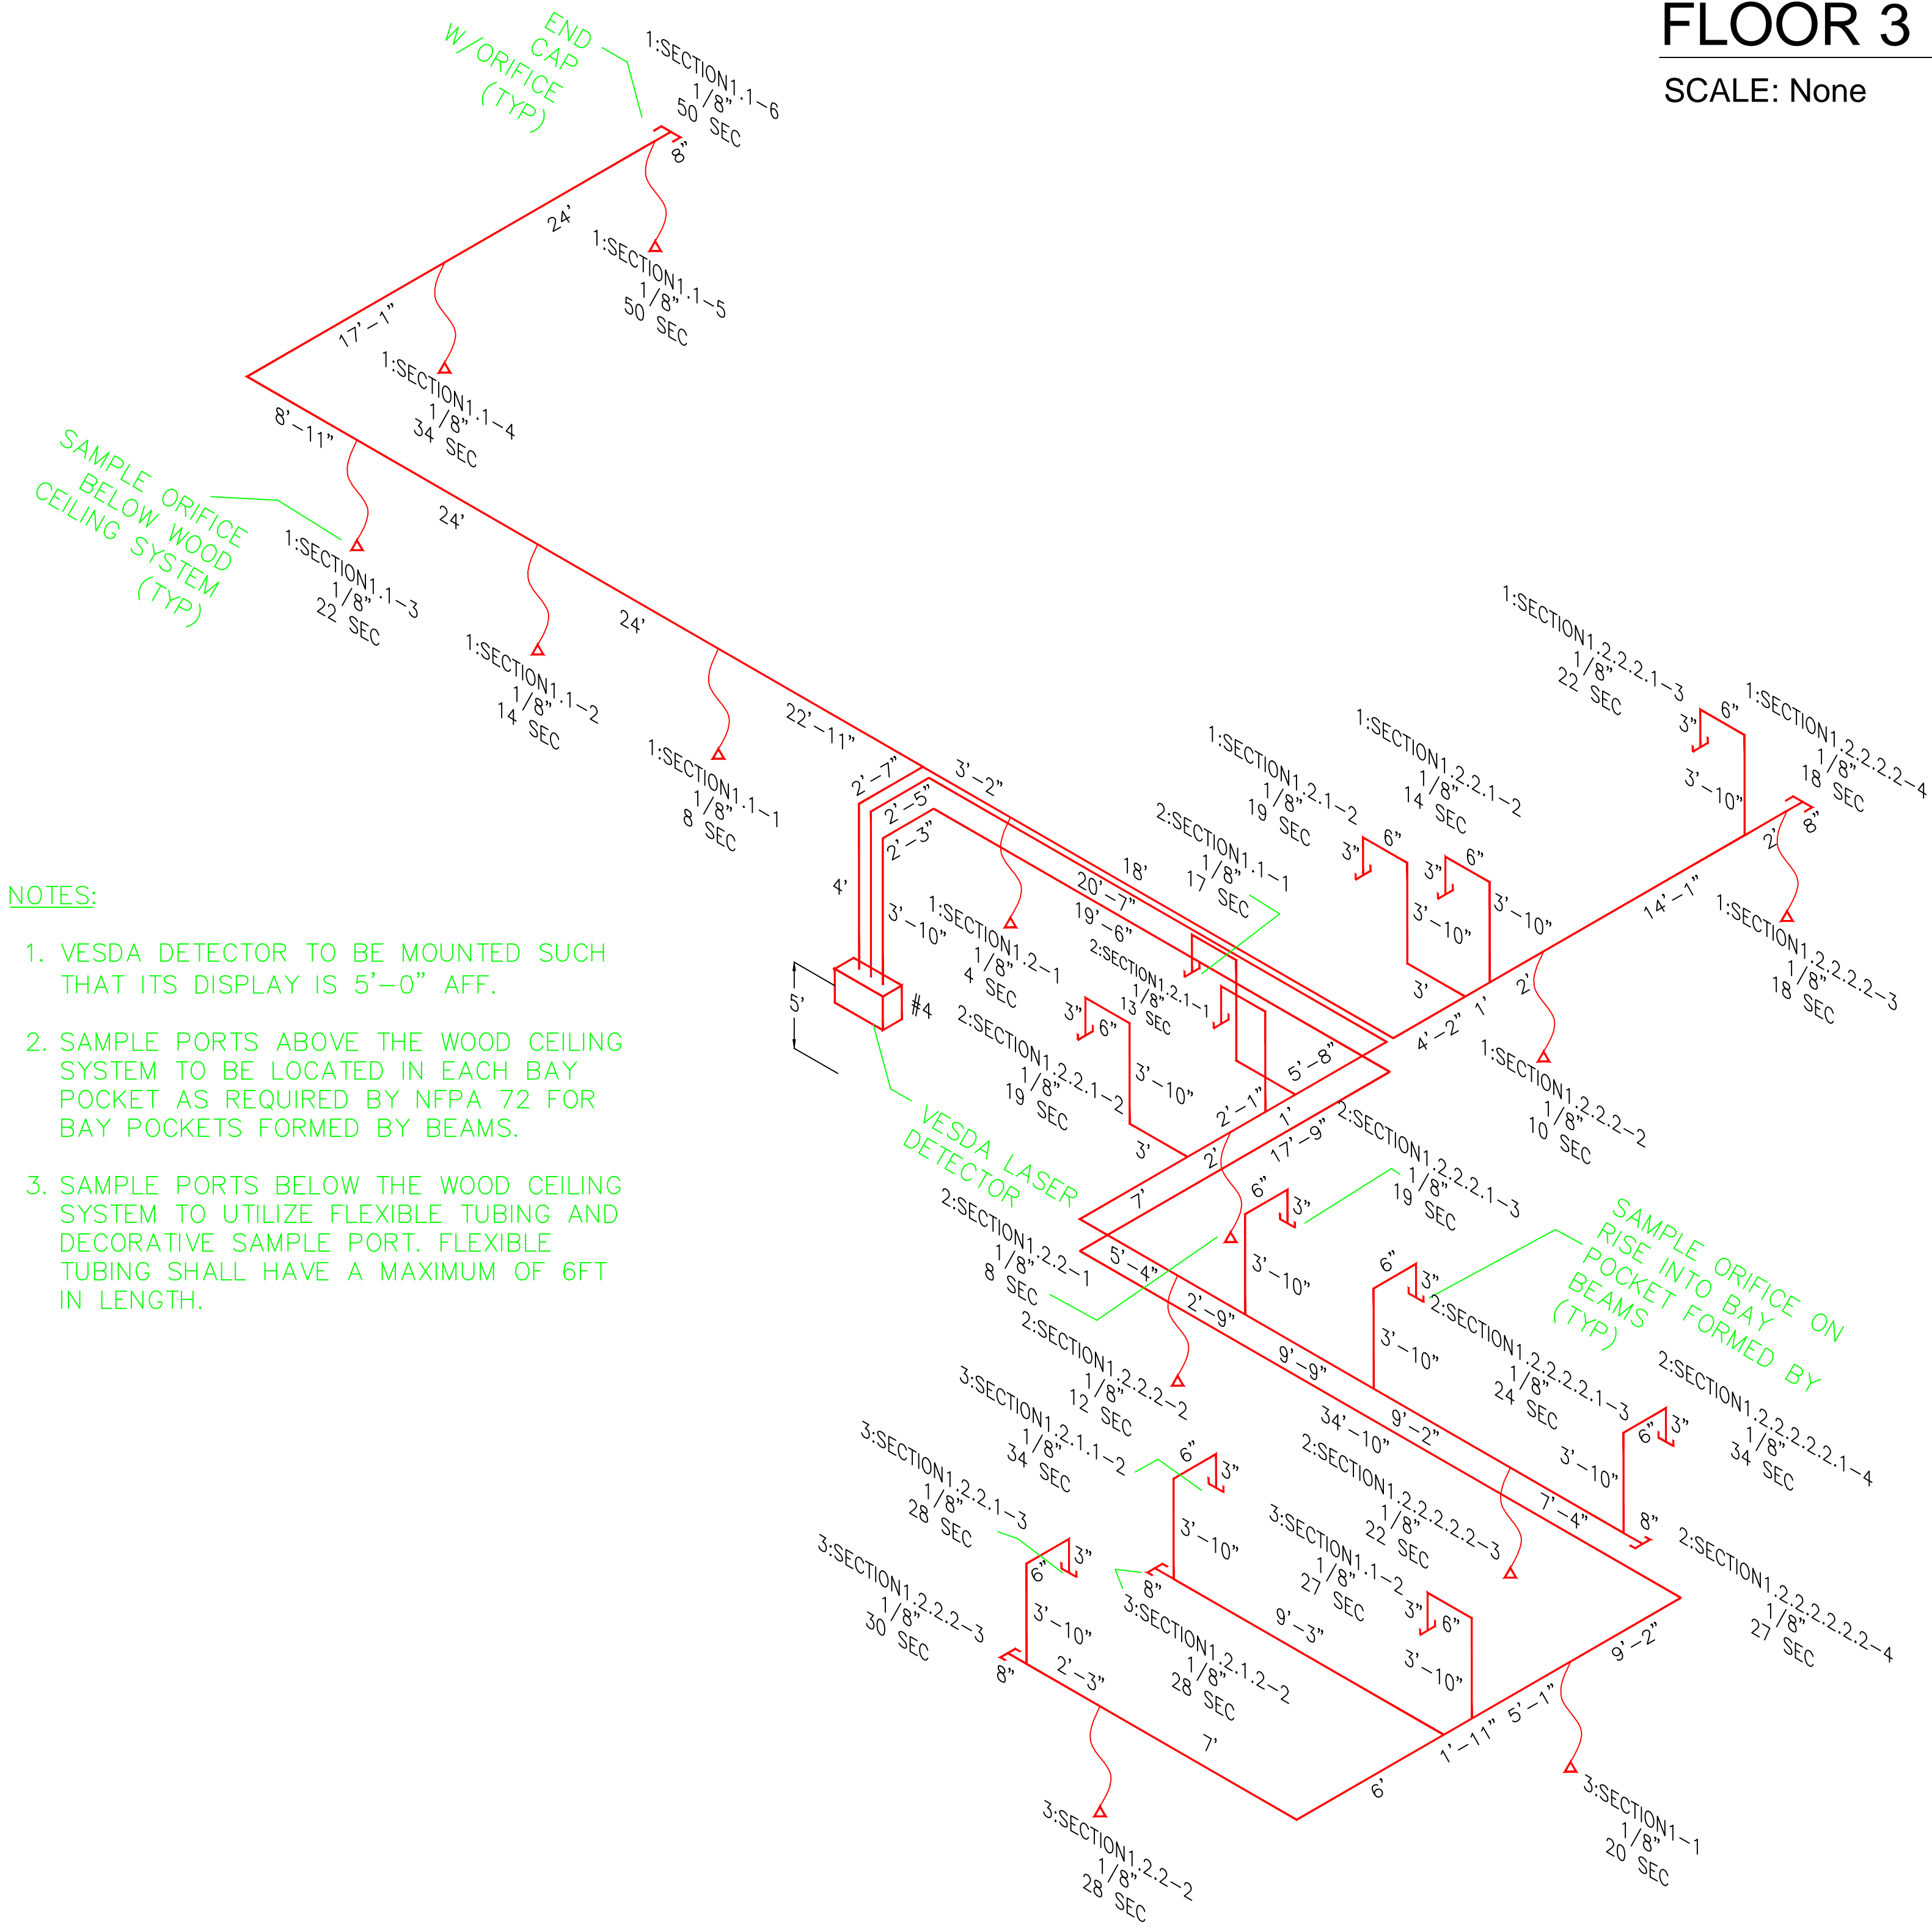

- NOTES:
- 1. VESDA DETECTOR TO BE MOUNTED SUCH THAT ITS DISPLAY IS 5'-0" AFF.
 - 2. SAMPLE PORTS ABOVE THE WOOD CEILING SYSTEM TO BE LOCATED IN EACH BAY POCKET AS REQUIRED BY NFPA 72 FOR BAY POCKETS FORMED BY BEAMS.
 - 3. SAMPLE PORTS BELOW THE WOOD CEILING SYSTEM TO UTILIZE FLEXIBLE TUBING AND DECORATIVE SAMPLE PORT. FLEXIBLE TUBING SHALL HAVE A MAXIMUM OF 6FT IN LENGTH.

	AS BUILT — 08/28/13									74 FIRE ALARM SYSTEM 3RD FLOOR HSSD PIPING SCHEMATIC	DRAWN BY DSV	DATE 08/28/13
											CHECKED BY LDD	09/03/2013
											APPROVED BY MCD	09/03/2013
											SCALE AS NOTED	
											UNIVERSITY OF CALIFORNIA LAWRENCE BERKELEY NATIONAL LABORATORY	
											FACILITIES DIVISION	
PROFESSIONAL SEAL (IF REVISION, APPLIES ONLY TO REVISED WORK)	ISSUE (PROGRESS, ESTIMATE, BID, CONSTRUCTION, CONFORMED, REVISION, RECORD)	REVISION NUMBER	DRAWN BY	CHECKED BY	APPR'D BY	DATE	REMARKS				DRAWING NO. 4B74E321	SHEET 20 OF 20
			DSV	LDD	MCD	08/28/13	AS BUILT FROM A/E RECORD DWGS				PROJECT NO. FN9200	